

# Design and Visual Communication

## AS 91339

### Exemplar F – Not Achieved

**AS91339: Produce instrumental perspective projection drawings to communicate design ideas (3 credits)**

Achievement	Achievement with Merit	Achievement with Excellence
Produce instrumental perspective projection drawings to communicate design ideas.	Produce instrumental perspective projection drawings to clearly communicate design ideas	Produce instrumental perspective projection drawings to effectively communicate design ideas.
<del>Uses perspective projection drawing <b>techniques</b> to communicate complex visual information.</del>	<del>Uses perspective projection drawing techniques to <b>skillfully</b> communicate complex visual information.</del>	<del>Demonstrate an ability to <b>select a viewpoint</b> that enables complex visual information of the design to be <b>effectively</b> communicated.</del>
The instrumental perspective drawing shows <b>design features</b> .	The instrumental perspective drawing <b>clearly</b> shows <b>detail</b> of the design features	The instrumental perspective drawing <b>accurately</b> shows <b>detail</b> of the design features

N

#### COMMENTS:

The setting-up of the VP's has not been accurately projected and therefore the perspective principles have not been applied correctly, preventing this drawing from achieving.


Although not all features in the perspective drawing are viewed in detail, there are enough drawn to enhance the view, allowing this drawing to achieve a low excellence for the bottom line.

PICTURE PLANE LINE

HEIGHT LINE

HORIZON LINE

GROUND LINE

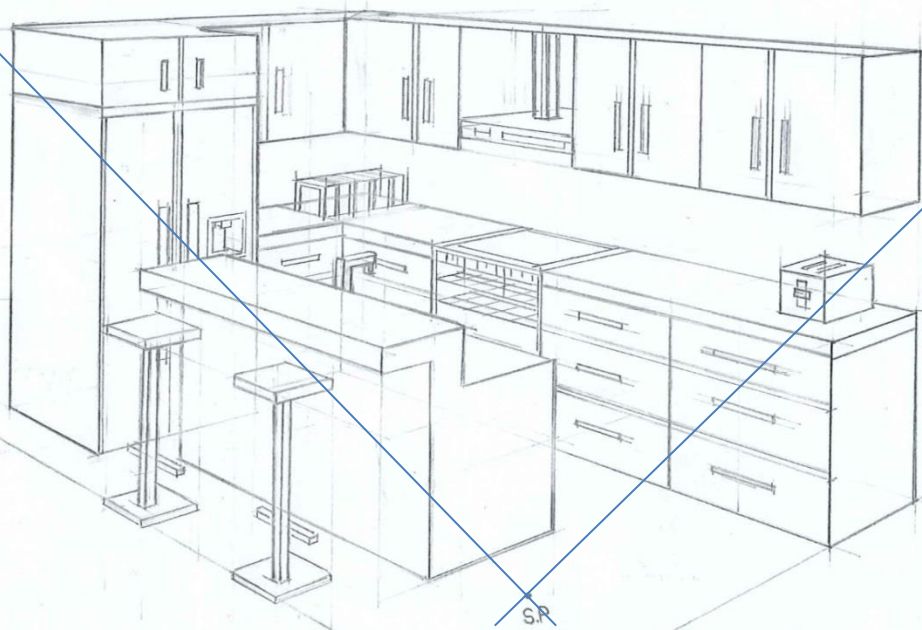

KITCHEN DESIGN

SCALE 1:50